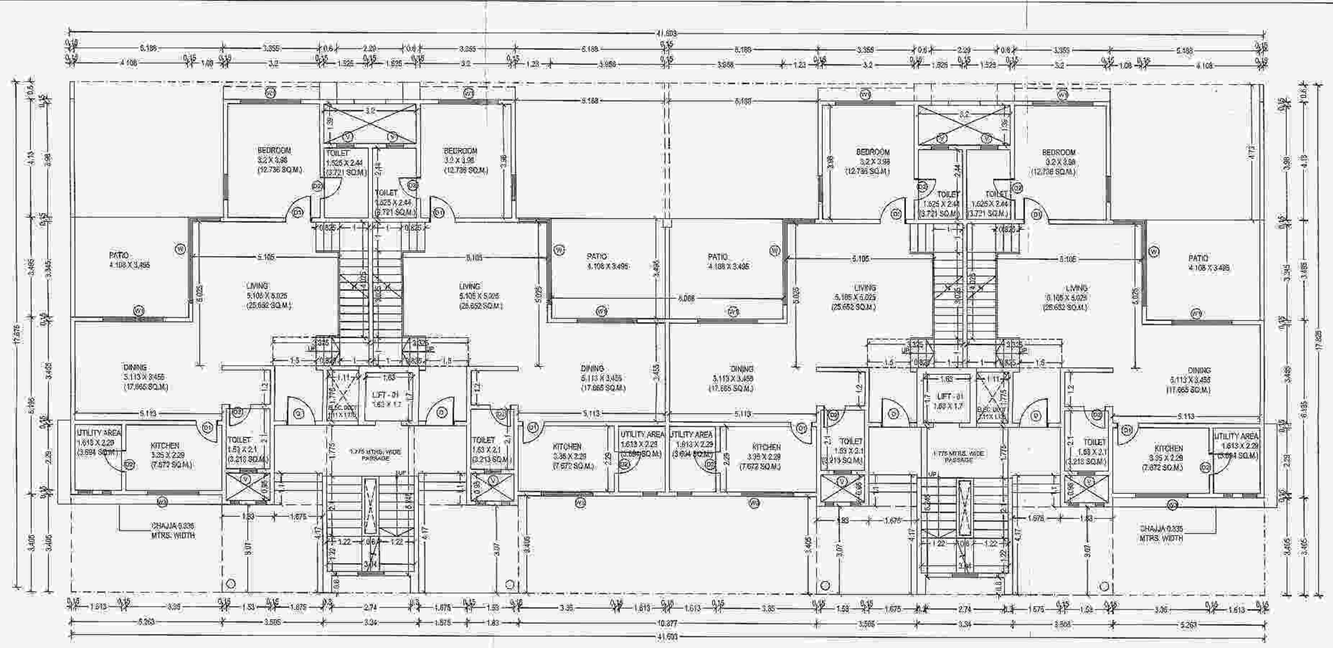

GROUND FLOOR PLAN

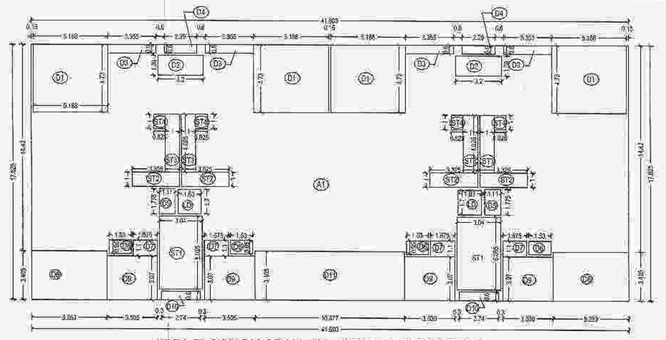

AREA BLOCK DIAGRAM FOR GROUND FLOOR PLAN
SCALE 1:200

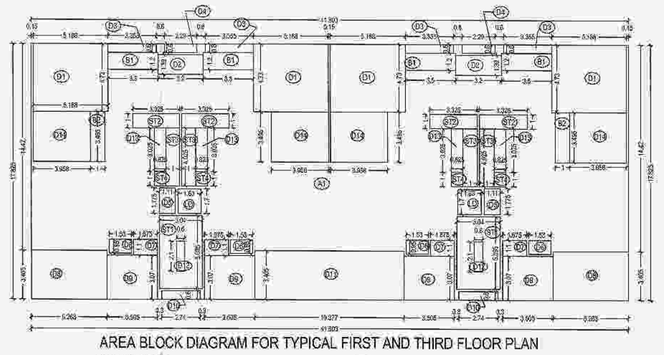

AREA BLOCK DIAGRAM FOR TYPICAL FIRST AND THIRD FLOOR PLAN
SCALE 1:200

AREA CALCULATION FOR GROUND FLOOR

Sr.no.	Discription	Type	Number	Length	Dimension Breadth	Altitude	Calculation	Answer	
Addition									
1	A1	Rectangle	1	41.025	17.835		Length X breadth	741.575	
							Total Additional area =	741.573	sq.m
Deductions									
2	D3	Rectangle	4	5.186	4.730		Length X breadth	98.197	
3	D2	Rectangle	2	3.200	1.350		Length X breadth	8.640	
4	D3	Rectangle	4	3.388	3.030		Length X breadth	8.640	
5	D4	Rectangle	3	2.200	0.800		Length X breadth	2.748	
6	D5	Rectangle	2	1.110	1.775		Length X breadth	3.941	
7	D6	Rectangle	4	1.530	0.960		Length X breadth	5.814	
8	D7	Rectangle	4	1.675	1.100		Length X breadth	7.370	
9	D8	Rectangle	2	5.353	3.405		Length X breadth	36.541	
10	D9	Rectangle	4	3.500	3.070		Length X breadth	43.041	
11	D10	Rectangle	2	2.740	0.600		Length X breadth	3.288	
12	D11	Rectangle	1	10.377	3.405		Length X breadth	35.334	
13	ST1	Rectangle	2	1.040	5.095		Length X breadth	30.978	
14	ST2	Rectangle	4	3.325	1.000		Length X breadth	13.300	
15	ST3	Rectangle	4	4.025	1.000		Length X breadth	16.100	
16	ST4	Rectangle	4	0.825	1.000		Length X breadth	3.300	
							Total Deduction area =	316.160	sq.m
A		TOTAL BUILT UP AREA = Additional - Deduction						825.413	sq.m
		NET BUILT UP AREA FOR FSI PURPOSE =						825.413	sq.m
Area of Staircase									
17	ST1	Rectangle	2	5.095	5.095		Length X breadth	30.978	
18	ST2	Rectangle	4	3.325	1.000		Length X breadth	13.300	
19	ST3	Rectangle	4	4.025	1.000		Length X breadth	16.100	
20	ST4	Rectangle	4	0.825	1.000		Length X breadth	3.300	
B		Total Staircase Area =						63.678	sq.m

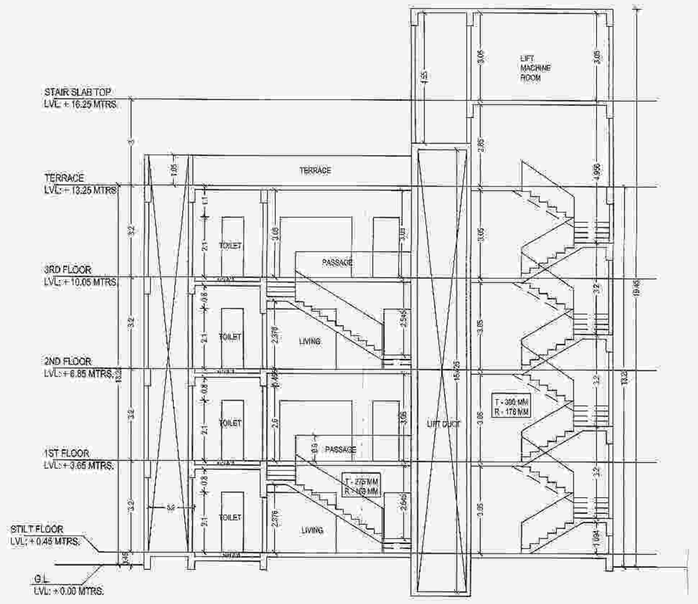

SECTION AT A -A'

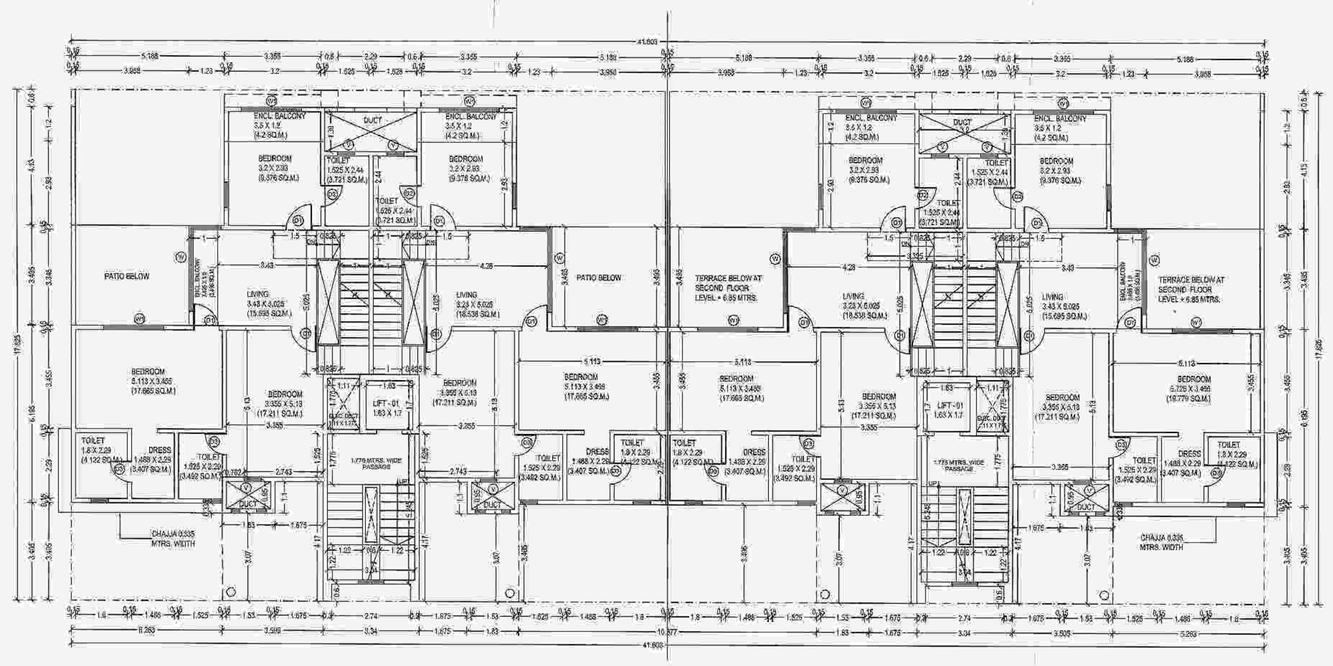

TYPICAL FIRST FLOOR PLAN

TYPICAL THIRD FLOOR PLAN

FRONT ELEVATION

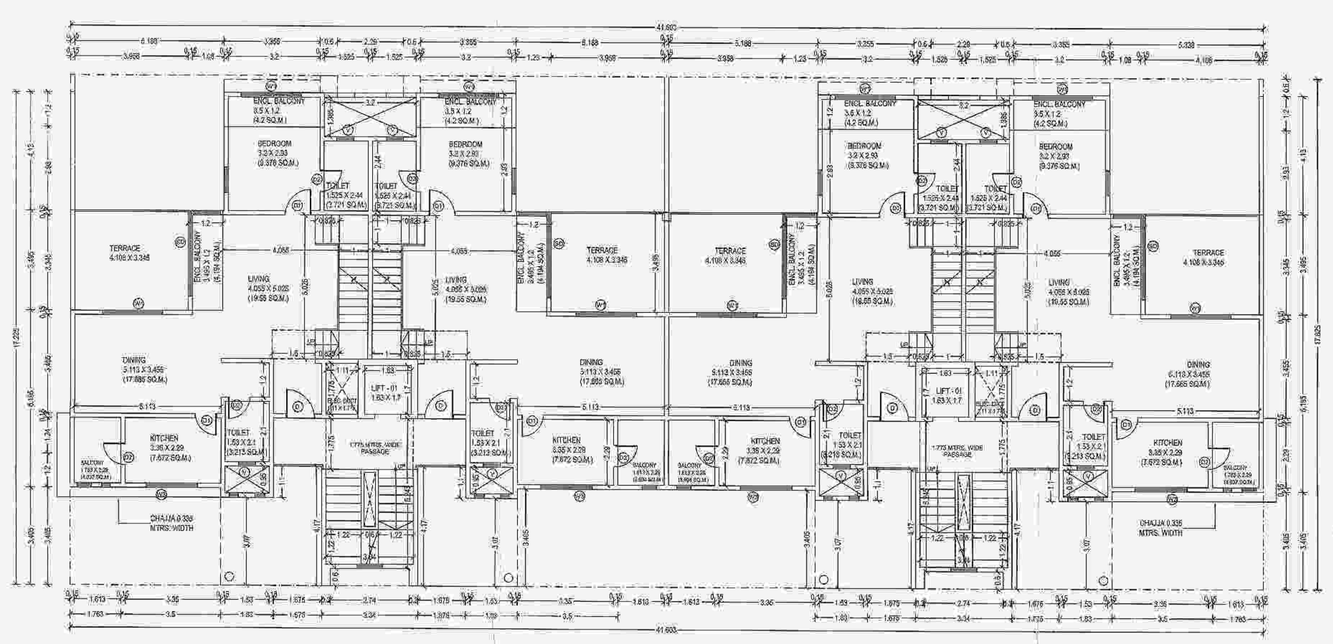

SECOND FLOOR PLAN

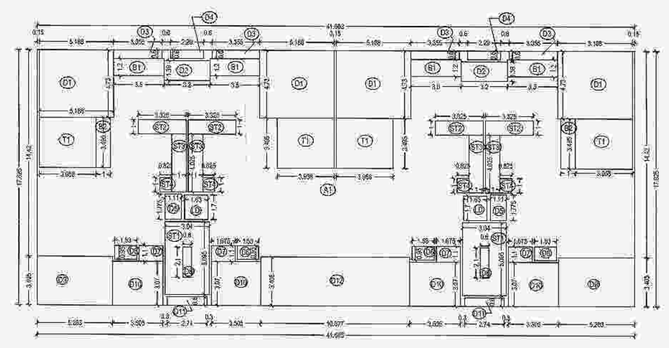

AREA BLOCK DIAGRAM FOR SECOND FLOOR PLAN
SCALE 1:200

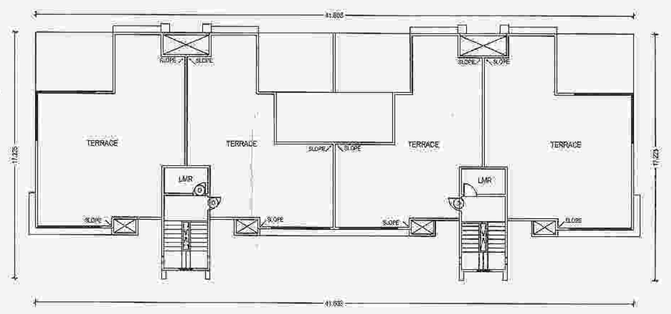

TERRACE FLOOR PLAN

AREA CALCULATION FOR SECOND FLOOR

Sr.no.	Discription	Type	Number	Length	Dimension Breadth	Altitude	Calculation	Answer	
Addition									
1	A1	Rectangle	1	41.025	17.835		Length X breadth	741.573	
							Total Additional area =	741.573	sq.m
Deductions									
2	D3	Rectangle	4	5.186	4.730		Length X breadth	98.197	
3	D2	Rectangle	2	3.200	1.350		Length X breadth	8.640	
4	D3	Rectangle	4	3.388	3.030		Length X breadth	8.640	
5	D4	Rectangle	3	2.200	0.800		Length X breadth	2.748	
6	D5	Rectangle	2	1.110	1.775		Length X breadth	3.941	
7	D6	Rectangle	4	1.530	0.960		Length X breadth	5.814	
8	D7	Rectangle	4	1.675	1.100		Length X breadth	7.370	
9	D8	Rectangle	2	5.353	3.405		Length X breadth	36.541	
10	D9	Rectangle	4	3.500	3.070		Length X breadth	43.041	
11	D10	Rectangle	2	2.740	0.600		Length X breadth	3.288	
12	D11	Rectangle	1	10.377	3.405		Length X breadth	35.334	
13	ST1	Rectangle	2	1.040	5.095		Length X breadth	30.978	
14	ST2	Rectangle	4	3.325	1.000		Length X breadth	13.300	
15	ST3	Rectangle	4	4.025	1.000		Length X breadth	16.100	
16	ST4	Rectangle	4	0.825	1.000		Length X breadth	3.300	
							Total Deduction area =	316.160	sq.m
A		TOTAL BUILT UP AREA = Additional - Deduction						425.413	sq.m
		NET BUILT UP AREA FOR FSI PURPOSE =						425.413	sq.m
		Permissible Balcony Area = 15% of Built Up Area =						63.812	sq.m
		Total Enclosed Balcony Area =						39.553	sq.m
Area of Staircase									
17	ST1	Rectangle	2	5.095	5.095		Length X breadth	30.978	
18	ST2	Rectangle	4	3.325	1.000		Length X breadth	13.300	
19	ST3	Rectangle	4	4.025	1.000		Length X breadth	16.100	
20	ST4	Rectangle	4	0.825	1.000		Length X breadth	3.300	
B		Total Staircase Area =						63.678	sq.m
		Total Permissible Balcony Area = 15% of Built Up Area =						63.812	sq.m
		Total Enclosed Balcony Area =						39.553	sq.m
C		Total Proposed Balcony Area = C =						23.799	sq.m
Area of Staircase									
19	ST1	Rectangle	2	5.095	5.095		(Length X breadth) - D2	30.978	
21	ST2	Rectangle	4	3.325	1.000		Length X breadth	13.300	
22	ST4	Rectangle	4	0.825	1.000		Length X breadth	3.300	
D		Total Staircase Area =						61.158	sq.m
Area of Lift									
23	L2	Rectangle	2	1.200	1.200		Length X breadth	5.542	
E		Total Lift Area =						5.542	sq.m
Area of Terrace									
24	TT	Rectangle	4	3.559	3.455		Length X breadth	36.339	
F		Total Terrace Area =						63.333	sq.m

AREA CALCULATION FOR TYPICAL FIRST TO THIRD FLOOR

Sr.no.	Discription	Type	Number	Length	Dimension Breadth	Altitude	Calculation	Answer	
Addition									
1	A1	Rectangle	1	41.483	17.835		Length X breadth	741.573	
							Total Additional area =	741.573	sq.m
Deductions									
2	D3	Rectangle	4	5.186	4.730		Length X breadth	98.197	
3	D2	Rectangle	2	3.200	1.350		Length X breadth	8.640	
4	D3	Rectangle	4	3.388	3.030		Length X breadth	8.640	
5	D4	Rectangle	3	2.200	0.800		Length X breadth	2.748	
6	D5	Rectangle	2	1.110	1.775		Length X breadth	3.941	
7	D6	Rectangle	4	1.530	0.960		Length X breadth	5.814	
8	D7	Rectangle	4	1.675	1.100		Length X breadth	7.370	
9	D8	Rectangle	2	5.283	3.405		Length X breadth	36.041	
10	D9	Rectangle	4	3.500	3.070		Length X breadth	43.041	
11	D10	Rectangle	2	2.740	0.600		Length X breadth	3.288	
12	D11	Rectangle	1	10.377	3.405		Length X breadth	35.334	
13	D12	Rectangle	1	6.800	2.100		Length X breadth	2.520	
14	D13	Rectangle	1	2.925	2.925		Length X breadth	8.663	
15	D14	Rectangle	4	3.958	3.445		Length X breadth	55.023	
16	J2	Rectangle	2	1.600	1.700		Length X breadth	5.440	
17	W1	Rectangle	4	1.800	1.200		Length X breadth	16.800	
18	W2	Rectangle	3	2.400	1.000		Length X breadth	8.100	
19	W3	Rectangle	1	3.240	0.085		(Length X breadth) - D9	25.460	
20	W5	Rectangle	1	1.800	2.200		Length X breadth	11.000	
21	W3	Rectangle	4	4.025	1.000		Length X breadth	16.100	
22	ST4	Rectangle	4	0.825	1.000		Length X breadth	3.300	
							Total Deduction area =	419.886	sq.m
A		TOTAL BUILT UP AREA = Additional - Deduction						330.765	sq.m
		NET BUILT UP AREA FOR FSI PURPOSE =						330.765	sq.m
		Permissible Balcony Area = 15% of Built Up Area =						49.615	sq.m
		Total Enclosed Balcony Area =						25.816	sq.m
23	W1	Rectangle	4	1.800	1.200		Length X breadth	16.800	
24	W2	Rectangle	2	2.400	1.000		Length X breadth	8.100	
B		Total Enclosed Balcony Area =						23.796	sq.m
C		Total Proposed Balcony Area = C =						23.796	sq.m
Area of Staircase									
25	ST1	Rectangle	2	5.095	5.095		(Length X breadth) - D2	25.459	
26	ST2	Rectangle	4	3.325	1.000		Length X breadth	13.300	
27	ST3	Rectangle	4	4.025	1.000		Length X breadth	16.100	
28	ST4	Rectangle	4	0.825	1.000		Length X breadth	3.300	
D		Total Staircase Area =						61.158	sq.m
Area of Lift									
29	L2	Rectangle	2	1.600	1.700		Length X breadth	5.542	
E		Total Lift Area =						5.542	sq.m

SR.NO.	DESCRIPTION	VALUE IN SQ.M.
	NET B.U.A./VOLUMN OF	
	GROUND FLOOR	425.413
	FIRST FLOOR	330.765
	SECOND FLOOR	396.719
	THIRD FLOOR	330.765
A	PROPOSED NET B.U.A.	1483.662
B	TOTAL AREA PROPOSED (RESIDENTIAL)	1483.662
	PREVIOUS SANCTIONED AREA	1299.978
	ADDITIONAL AREA IN FSI	194.684

SCHEDULE OF DOORS & WINDOWS

TYPE	SIZE OF OPENING	AREA IN SQ.M.	DESCRIPTION
D	1.0 X 2.1	2.100	FLUSH DOOR
D1	0.9 X 2.1	1.890	FLUSH DOOR
D2	0.75 X 2.1	1.575	FLUSH DOOR
FD	1.0 X 2.1	2.100	FIRE RETARDANT DOOR
SD	2.4 X 2.1	5.040	ALUMINIUM SLIDING DOOR
SD1	2.1 X 2.1	3.780	ALUMINIUM SLIDING DOOR
W	2.4 X 1.5	3.600	FULLY GLAZED ALUMINIUM SLIDING WINDOW
W1	2.4 X 1.2	2.880	FULLY GLAZED ALUMINIUM SLIDING WINDOW
W2	2.1 X 1.2	2.520	FULLY GLAZED ALUMINIUM SLIDING WINDOW
W5	1.8 X 1.2	2.160	FULLY GLAZED ALUMINIUM SLIDING WINDOW
W2	1.2 X 0.9	1.080	FULLY GLAZED ALUMINIUM SLIDING WINDOW
V	0.6 X 0.6	0.360	FULLY GLAZED ALUMINIUM SLIDING WINDOW

HEIGHT OF THE BUILDING: 13.25 MTRS.

1) **WATER SUPPLY REQUIREMENT:**

DOMESTIC IN LITERS			FIRE FIGHTING IN LITERS		
TOTAL REQUIREMENT 2450 LITERS	U/G	O/H	U/G	O/H	
	1350	1350			

2) **SANITORY REQUIREMENT:**

FLOOR	NO. OF WC REQUIRED	NO. OF WC PROVIDED
GROUND		
FIRST	8NOS.	16 NOS.
SECOND		
THIRD	8NOS.	17 NOS.

3) **PARKING REQUIREMENT:**

FOUR WHEELER CAR PARKING SPACE

CARPET IN SQ.M.	NO. OF FLATS	REQUIRED CAR	REQUIRED 2 WHEELER
147.899	8	12	16
TOTAL	8		

5) **LIGHT & VENTILATION STATEMENT**

DESCRIPTION OF USER SPACE	CARPET AREA OF RM. IN SQ.M.	L&V REQUIRED 1/10TH OF CARPET AREA	L&V PROVIDED IN SQ.M.	TYPE OF OPENING USED
LIVING ROOM	25.652	2.565	2.88	W1
DINING	17.655	1.767	2.88	W1
FAMILY ROOM	15.695	1.570	2.88	W1
BED ROOM 01	19.778	1.978	2.88	W1
BED ROOM 02	12.736	1.274	2.52	W2
BED ROOM 03	9.376	0.938	2.52	W2
KITCHEN	7.872	0.787	1.08	W4
TOILET 01	3.733	0.373	0.36	V
TOILET 02	3.213	0.321	0.36	V

6) **GROSS AREA STATEMENT:**

FLOOR	NET B/U AREA IN SQ.M. (A)	PROPOSED BALCONY AREA IN SQ.M. (B)	TOTAL TERRACE AREA IN FSI	STAIRCASE & LIFT AREA C		TOTAL BUILT UP IN SQ.M. (A+B+C+)
				LIFT	STAIRS	
GROUND	425.413			5.542	63.678	494.633-489.091
FIRST	330.765	23.799	0	5.542	61.158	421.255
SECOND	396.719	23.799	55.333	5.542	61.158	487.226
THIRD	330.765	23.799	0	5.542	61.158	421.255
TOTAL	1483.662	71.370	55.333	16.626	247.152	1818.910
			OVER ALL GROSS AREA :			1824.352 1818.910

Duplex Homes

	Net Bup	Gross B/up
(G+3)		
1 BLDG -	1483.662	1824.352
8 BLDG →	X 8	X 8
Total.	11869.296	14594.816 . M²

AS-BUILT DRAWING 14

PROJECT TITLE:
BLOOMDALE
BY: MAHINDRA LIFESPACES

LOCATION:
SITUATED AT MIHAN, AT MOUZA - KHAPRI (RLY) KHASARA NO. 17(PART), 18(PART), 19(PART), 26(PART), 27(PART), 28, 29 (PART), 30 (PART), 31 (PART), 35 (PART), 36 (PART), 59 (PART), HINGNA P.S., KHAPRI POST OFFICE, NAGPUR DISTRICT.

APPROVAL STAMP

AS BUILT DRAWING
Additional Chief Planner
Maharashtra Airport Development Co. Ltd.

Checked & Found in order

KEY PLAN :

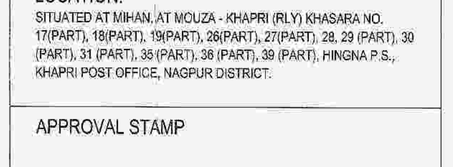

NORTH

NO.	DATE	REVISION

DRAWING TITLE :
AS-BUILT DRAWING
BUILDING TYPE - DUPLEX HOMES
FLOOR PLANS

SCALE - 1:100 | DATE: 02 - 11 - 2011

NORTH | DRAWING NO: SB - PL - DH - 01

CLIENT:
MAHINDRA BEBANCO DEVELOPERS LIMITED
MAHINDRA TOWERS, 6TH FLOOR, WORLI, MUMBAI - 400 018

CLIENT'S SIGNATURE

ARCHITECT:
PARAG KOTWAL
287, 'GUNJARI', 1ST FLOOR, W.H.C. ROAD, LAXMI NAGAR, NAGPUR - 22.

ARCHITECT'S SIGNATURE