

PRODUCED BY AN AUTODESK EDUCATIONAL PRODUCT

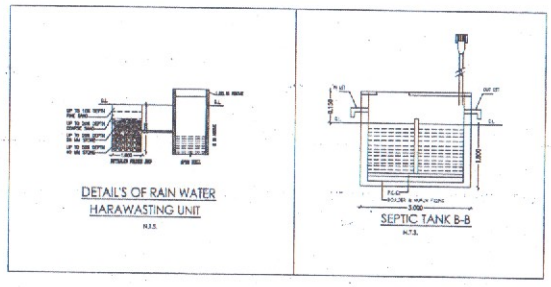

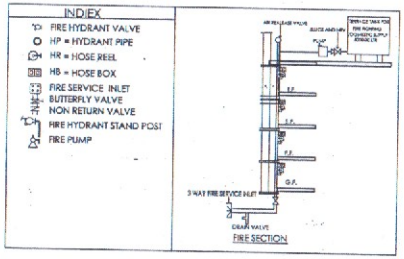


Permission is granted as per building DCPR bye-laws & M.R.T.P Act 1966, vide letter no. T.P.O. 0019 Date : 5.6.19 & 5.6.19 and necessary Corrections/changes by red lines.

Applicant

Architect / Engineer / Supervisor

Owner / Developer / Power Holder / Agency

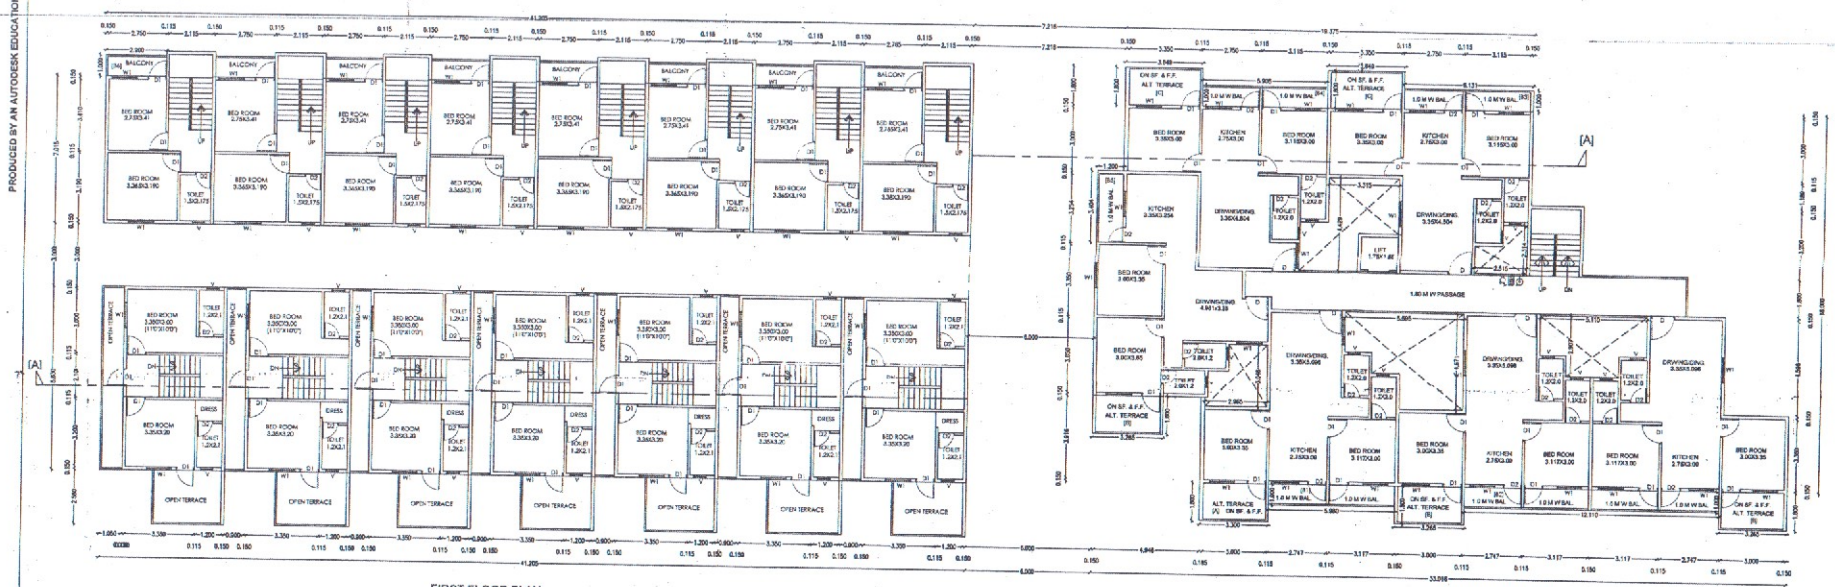

PROPOSED RESIDENTIAL BUILDING FOR MULTY FAMILY DWELLING-UNIT ON PLOT NO 55,56,57,58 & 59 ,KH NO.-138,139 P.H. NO-49 MOUZA-HINGNA,-DIST.-NAGPUR.

BELONGING TO-

MRS.-VANDANA GOPALRAO DHAWAD

MRS.-INDIRA NAMDEVRAO PADOLE

BALCONY AREA STATEMENT

PERMISSIBLE BAL. AREA ON FIRST FLOOR 15 % OF 1011.734 SQ.M. = 151.758 SQ.M.

PROVIDED OPEN BAL.-

[F1] 5.950 X 1.00	= 5.950
[B2] 12.11 X 1.00	= 12.11
[B3] 5.131 X 1.00	= 5.131
[B4] 5.908 X 1.00	= 5.908
[B5] 3.404 X 1.20	= 4.084
[B6] 8(2.960 X 1.0)	= 23.680
TOTAL	= 57.413 SQ.MT

PERMISSIBLE BAL. AREA ON SECOND FLOOR 15 % OF 391.556 SQ.M. = 58.733 SQ.M.

PROVIDED OPEN BAL.-

[B1] 5.950 X 1.00	= 5.950
[B2] 12.11 X 1.00	= 12.11
[B3] 5.131 X 1.00	= 5.131
[B4] 5.908 X 1.00	= 5.908
[B5] 3.404 X 1.20	= 4.084
TOTAL	= 34.213 SQ.MT

THIRD FLOOR BAL. AREA = 34.213 SQ.MT (SAME AS SECOND FLOOR)

FOURTH FLOOR BAL. AREA = 34.213 SQ.MT (SAME AS SECOND FLOOR)

D.H.ALT.TERRACE

PERMISSIBLE ALT. TERRACE ONSECOND & FOURTH FLOOR @20%OF 391.556 SQ.MT ——— 78.311 SQ.MT

[A] 3.350 X 1.500	= 5.025
[B] 3X(1.250 X 1.80)	= 17.631
[C] 2X(3.660 X 1.80)	= 13.176
TOTAL	= 35.832 SQ.MT

PARKING AREA STATEMENT

PARKING REQUIRED 25 TENAMENT HAVING BUP AREA 50 TO 100 SQ.MT

6 CAR + 38 SCOOTER + 38 CYCLE

SCHEDULE OF OPENING

NO	SIZE	REMARK
D	1.000 X 2.100	T.W. PANNEL DOOR
D1	1.000 X 2.100	T.W. PANNEL DOOR
D2	0.750 X 2.100	T.W. PANNEL DOOR
W	1.800 X 1.200	T.W. GLAZED WINDOW
W1	1.200 X 1.200	T.W. GLAZED WINDOW
V	0.600 X 0.600	M.S. VENTILATOR

INDEX

PLOT BOUNDARY SHOWN IN

PROPOSED CONVER, SHOWN IN

WATER CONVER, SHOWN IN

SEPTIC TANK CHAMBER SHOWN IN

SEPTIC TANK OUTLET SHOWN IN

S.T.P.

SUBMISSION DRAWING

DATE:- SCALE-1:100,1:200

SIGN OF OWNER

DRG BY- ROSHAN DATE

DRG NO- [02/03]

N

For Mrs. V. G. Dhawad

Smt. I. N. Padole.

SIGN OF ENGINEER/ARCHITECT

ROSHAN DATE
Consulting Civil Engineer
NMC Lic No.:-700
NIT Lic No.:-2589

PRODUCED BY AN AUTODESK EDUCATIONAL PRODUCT