
COMPLETION PLAN FOR GREYWATER RECYCLING & REUSE PLAN ON KH. NO. 30/3/K P.H.NO.42 MOUZA-SHANKARPUR TAH.- NAGPUR (RURAL) - DISTT. NAGPUR

BELONGING TO

SHRI ANISH BHAWARILAL CHHAJED

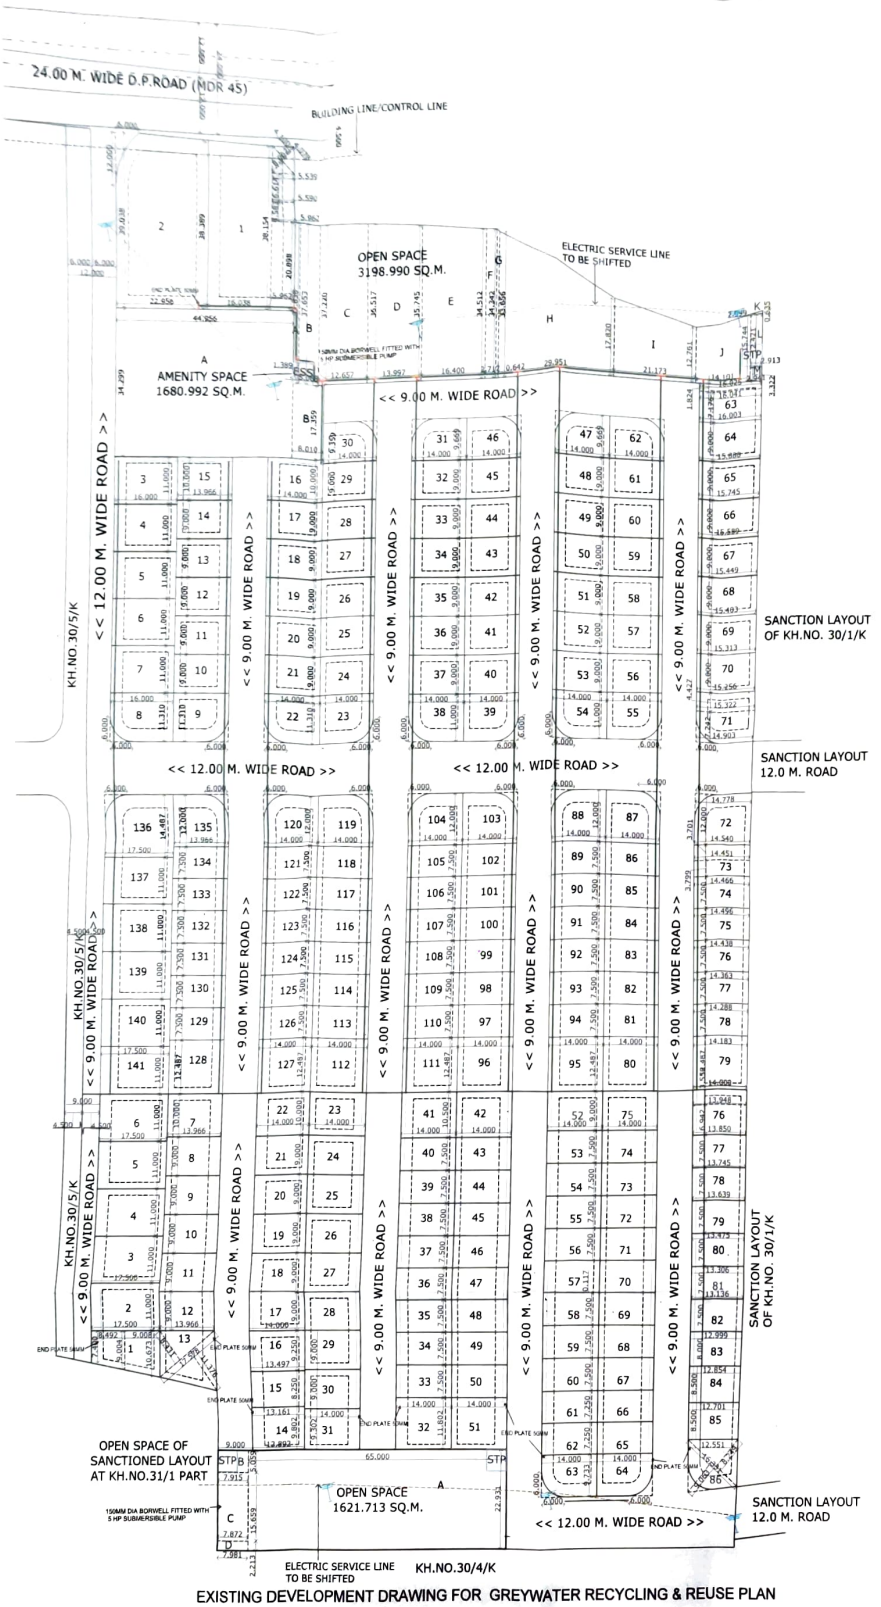

EXISTING DEVELOPMENT DRAWING FOR GREYWATER RECYCLING & REUSE PLAN

GREY WATER PIPELINE SHOWN IN GREEN COLOUR SHOULD NOT BE USED FOR DRINKING (POTABLE WATER) PURPOSE AS IT IS HAZARDOUS TO HEALTH IT SHOULD BE EXCLUSIVELY USED FOR GARDENING ,WASHING PURPOSE ONLY DEVELOPER SHOULD AWARE THE PLOT HOLDER REGARDING GREY WATER

LEGEND : -

S.NO.	NAME	SYMBOLS
1	WATER PIPE LINE 50 MM DIA HDPE PIPE	——
2	END PLATE 50 MM	⊥
3	A/F TEE 50 MM	⊤

OWNER :

SHRI ANISH BHAWARILAL CHHAJED

ARCHITECT/LICENSED ENGINEER :

Pawan Rajmohanlal Gupta
B.E. (CIVIL)
PLANNERS, BUILDERS AND DEVELOPERS
Lic.No.N.I.T.1998/M.M.R.D.A. 2k.N.M.C.380
Off. Shop No.115 Second Floor,
Shriram Shyam Tower, Sadar Nagpur-440001.
Email ID :pawan_r_gupta@yahoo.co.in
MOB.No.9823432949

EMAIL ID - pawan_r_gupta@yahoo.co.in MOBILE NO.9823432949

DRG. NO.	SCALE	DATE	DRAWN BY
SUB-01	NTS	16 / 02 / 2022	G.KAWAS

S.E.(METRO) N.M.R.D.A.	E.E.(M-2) N.M.R.D.A.	A.E. (METRO -) N.M.R.D.A.	A.E.-II N.M.R.D.A.