
COMPLETION PLAN FOR PROPOSED GREYWATER RECYCLING & REUSE PLAN ON KH. NO. 16/1 P.H.NO.42 MOUZA-GAWSI MANAPUR .TAH.- NAGPUR (RURAL) - DISTT. NAGPUR.

BELONGING TO,
SHRI. RAHUL JAGDISH BONDRE
SHRI. ANISH BHAWARILAL CHAJED
SHRI. ABHIJEET BAPURAOJI DUDHANE
SHRI. MADHAV VAMANRAO DESHPANDE

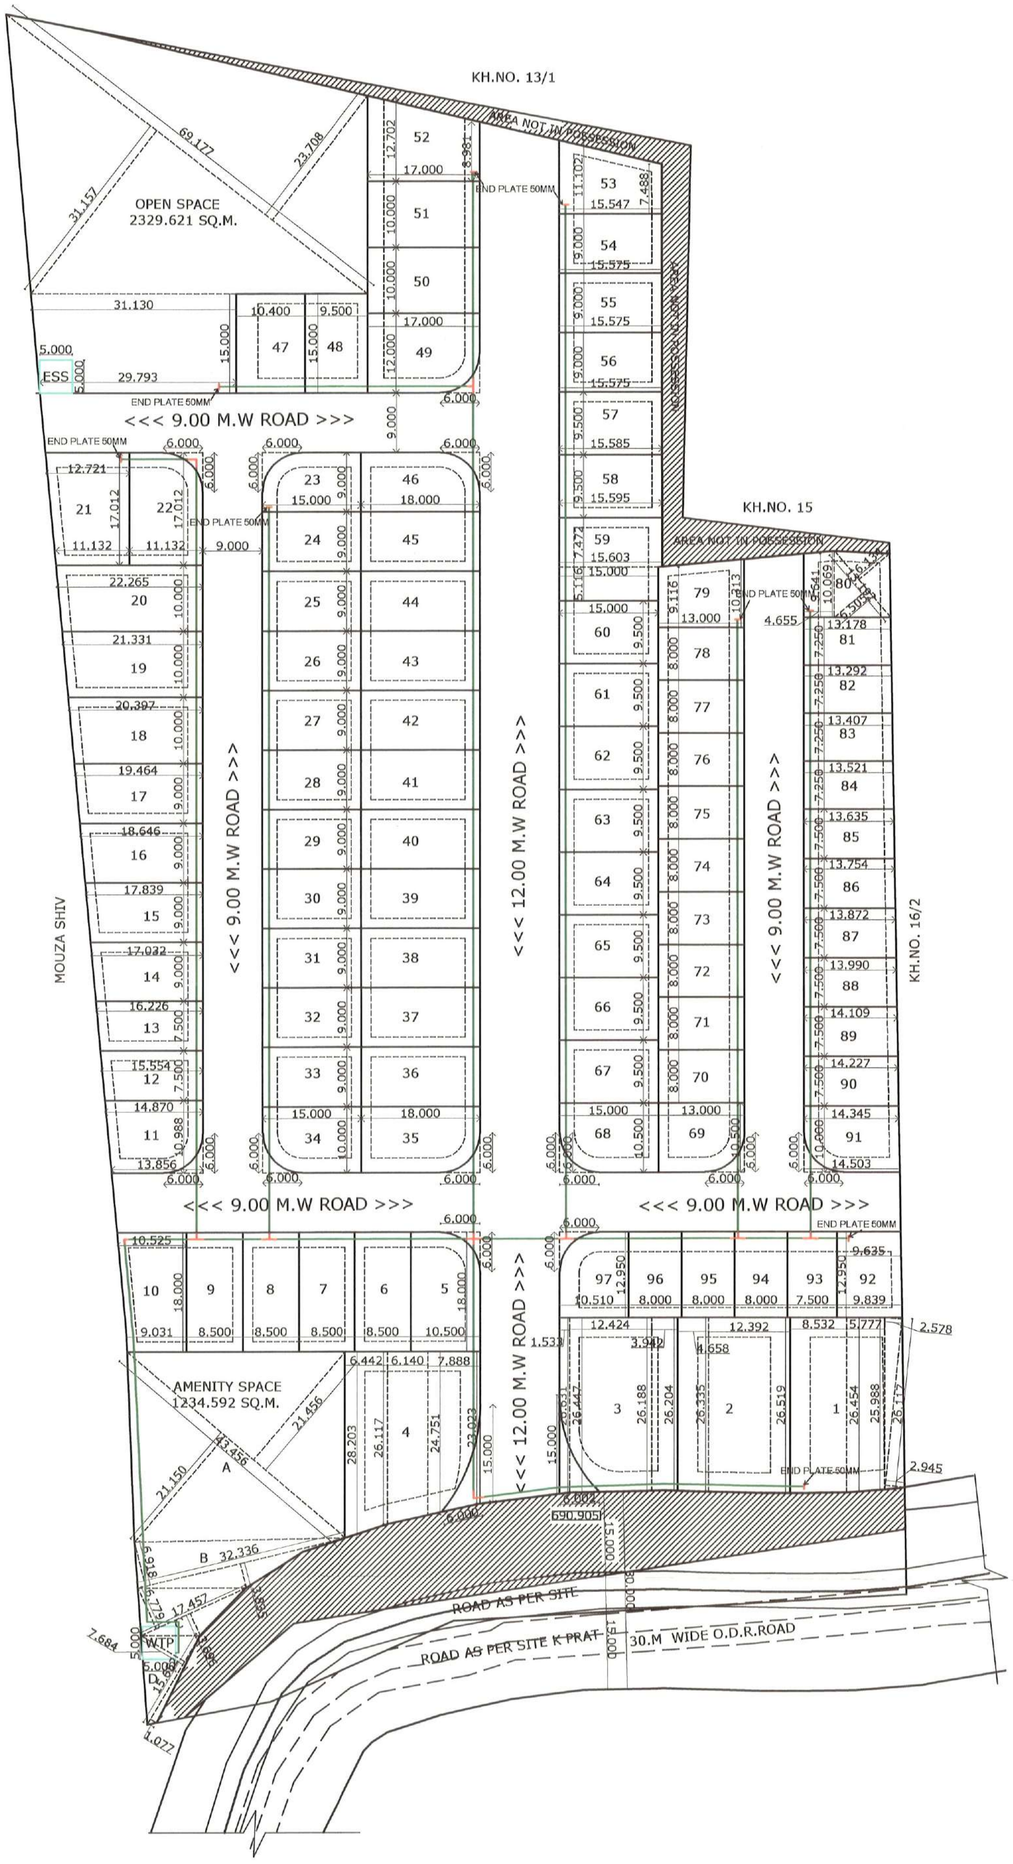

EXISTING DEVELOPMENT DRAWING FOR GREYWATER RECYCLING & REUSE PLAN

GREY WATER PIPELINE SHOWN IN GREEN COLOUR SHOULD NOT BE USED FOR DRINKING (POTABLE WATER) PURPOSE AS IT IS HAZARDOUS TO HEALTH IT SHOULD BE EXCLUSIVELY USED FOR GARDENING ,WASHING PURPOSE ONLY DEVELOPER SHOULD AWARE THE PLOT HOLDER REGARDING GREY WATER

LEGEND : -		
S.NO.	NAME	SYMBOLS
1	WATER PIPE LINE 50 MM DIA HDPE PIPE	
2	END PLATE 50 MM	|
3	A/F TEE 50 MM	T

OWNER :

SHRI. RAHUL JAGDISH BONDRE

SHRI. ANISH BHAWARILAL CHAJED

SHRI. ABHIJEET BAPURAOJI DUDHANE

SHRI. MADHAV VAMANRAO DESHPANDE

ARCHITECT/LICENSED ENGINEER :

Pawan Raviprasad Gupta
B.E. (CIVIL)
PLANNERS, BUILDERS AND DEVELOPERS,
Lic. No.N.I.T. 1969,N.M.R.D.A. 39, N.M.C.380
Off.: Shop No.115 Second Floor,
Shriram Shyam Tower, Sadar Nagpur-440001.
E-mail ID. pawan_r_gupta @yahoo.co.in
MOB. No.9923432949.

EMAIL ID - pawan_r_gupta@yahoo.co.in MOBILE NO.9923432949

DRG. NO.	SCALE	DATE	DRAWN BY
SUB-01	NTS	30 / 06 / 2023	G.KAWAS

N

Superintending Engineer S.E.(METRO) N.M.R.D.A.	Executive Engineer E.E.(M-2) N.M.R.D.A.	Assistant Engineer-I (South) A.E. (METRO) N.M.R.D.A.	A.E.-II N.M.R.D.A.