Application No. 3104/2021
Certified Copy of 9/3/21
Case No. 230/NAP-34/2021

SANCTION LAY OUT

जिल्हाधिकारी यांचे कार्यालय, नागपूर

सहा. संचालक नगर रचना व मुल्यनिर्धारण विभाग, नागपूर यांचे कार्यालयीन पत्र क्र. 1744 दिनांक 17/04/10 मधील अटी अन्वये निवासी वापराकरिता मंजूरीची शिफारस करण्यात आलेली असून आभिन्यासातंर्गत रस्ते रस्त्यावरील दिवे (स्ट्रीट लाईट), नाल्या (ड्रेन), आणि पाणी पुरवठा इत्यादी प्राथमिक सोई अनुशंगाने यांनी अभिन्यासालीत (ले-आऊट) मधील धारकांना उपलब्ध करून देणे बंधनकारक राहील. या व कार्यालयीन आदेश पत्र क्रमांक प्रस्तुत/जिल्हाधिकारी/कावि/127/11 रा.मा.क्र.230/एनएपी 34/10:11 दिनांक 21/1/11 मधील अटी व शर्तीस अधिन राहून मौजा Besa तह. Nagpur (R) ह.न. 38 प.ह.न. 50 आराजी 1.24 हे.आर 3300 चौ. मी. जागेच्या अभिन्यासास निवासी वापराकरीता मंजूरी प्रदान करण्यात येत आहे.

जिल्हाधिकारी, नागपूर करिता

9.00 M WIDE APROACH ROAD

6.0 M WIDE APROACH ROAD

34.00
Ammenity space
~~PUBLIC UTILITY~~
332.430SQM.
9.85
33.50
PLOT NO 1
54.80
31.10
OPEN SPACE
339.16 SQM.
9.50
12.70

9.00 M.WIDE ROAD

6.0 M WIDE APROACH ROAD

12.00 M.WIDE D.P. ROAD

SANCTION LAY OUT

नगर रचना व मुल्यनिर्धारण विभाग, शाखा कार्यालय, नागपूर.
.....रंगाने दुरुस्ती केल्याप्रमाणे या कार्यालयाचे पत्र क्र. रसपंनाशा/9348 दि. 26/8/20 अटी अन्वये निवासी वापरा करीता अंतिम मंजूरीची शिफारस करण्यात येत आहे.

सहायक संचालक
नगर रचना, नागपूर

Date of application 04/06/2021
Fold to appear on 04/06/2021
Date of appearance 04/06/2021
Copy ready on 09/06/2021
Copy delivered on 09/06/2021
Cost of Copy nil

Copied by Compared by Head Copyist
Collectorate Nagpur

TRUE COPY
Head Copyist
Collectorate Nagpur

N

LAY OUT PLAN

SCALE 1:500

DEMARCATED RESIDENTIAL LAY OUT PLAN ON KH NO.50 PART , P.H.NO.38 MOUZA-BESA ,TAH- NAGPUR(Gr). DIST-NAGPUR

OWNER :-


AREA STATEMENT

TOTAL LAND AREA ON KH.NO 50 PART	=	3300.00	SQMT.
AREA UNDER PLOTS	=	1770.04	SQMT.
AREA UNDER OPEN SPACE Ammenity Space.	=	339.16	SQMT.
AREA UNDER ~~PUBLIC UTILITY~~	=	332.43	SQMT.
AREA UNDER ROADS	=	858.37	SQMT.

SCHEDULE OF PLOTS

SR.NO	PLOT NO	PLOT SIZE	TANGENT	AREA	NO OF PLOTS	TOTAL AREA
1	1	(33.50+31.10)/2X54.80	---	1770.04	1	1770.04

SITE PLAN:-

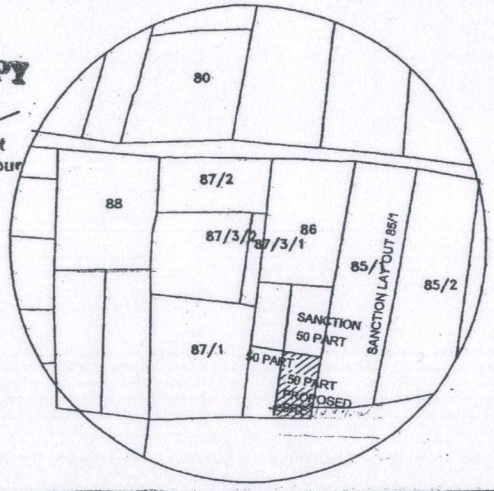

N

MOUZA-BESA
P.H.NO.38
TAH-NAGPUR (Gr)
DIST- NAGPUR
SCALE 1:5000

OWNER SIGN:-

ARCHITECT SIGN:-

Received Rs. 30/- in Words Rupees...Thirty...
Rs fee for this certified copy.
09/06/2021
Head Copyist
Collectorate Nagpur

ASPECT DESIGN
B. P. GOHAR
Consulting Architect & Engineer
N.I.T. L.S. No.-686, N.M.C. L.S. No.39(
8, Sentali Colony, Dev Nagar,
NAGPUR. Ph.No. 2259144