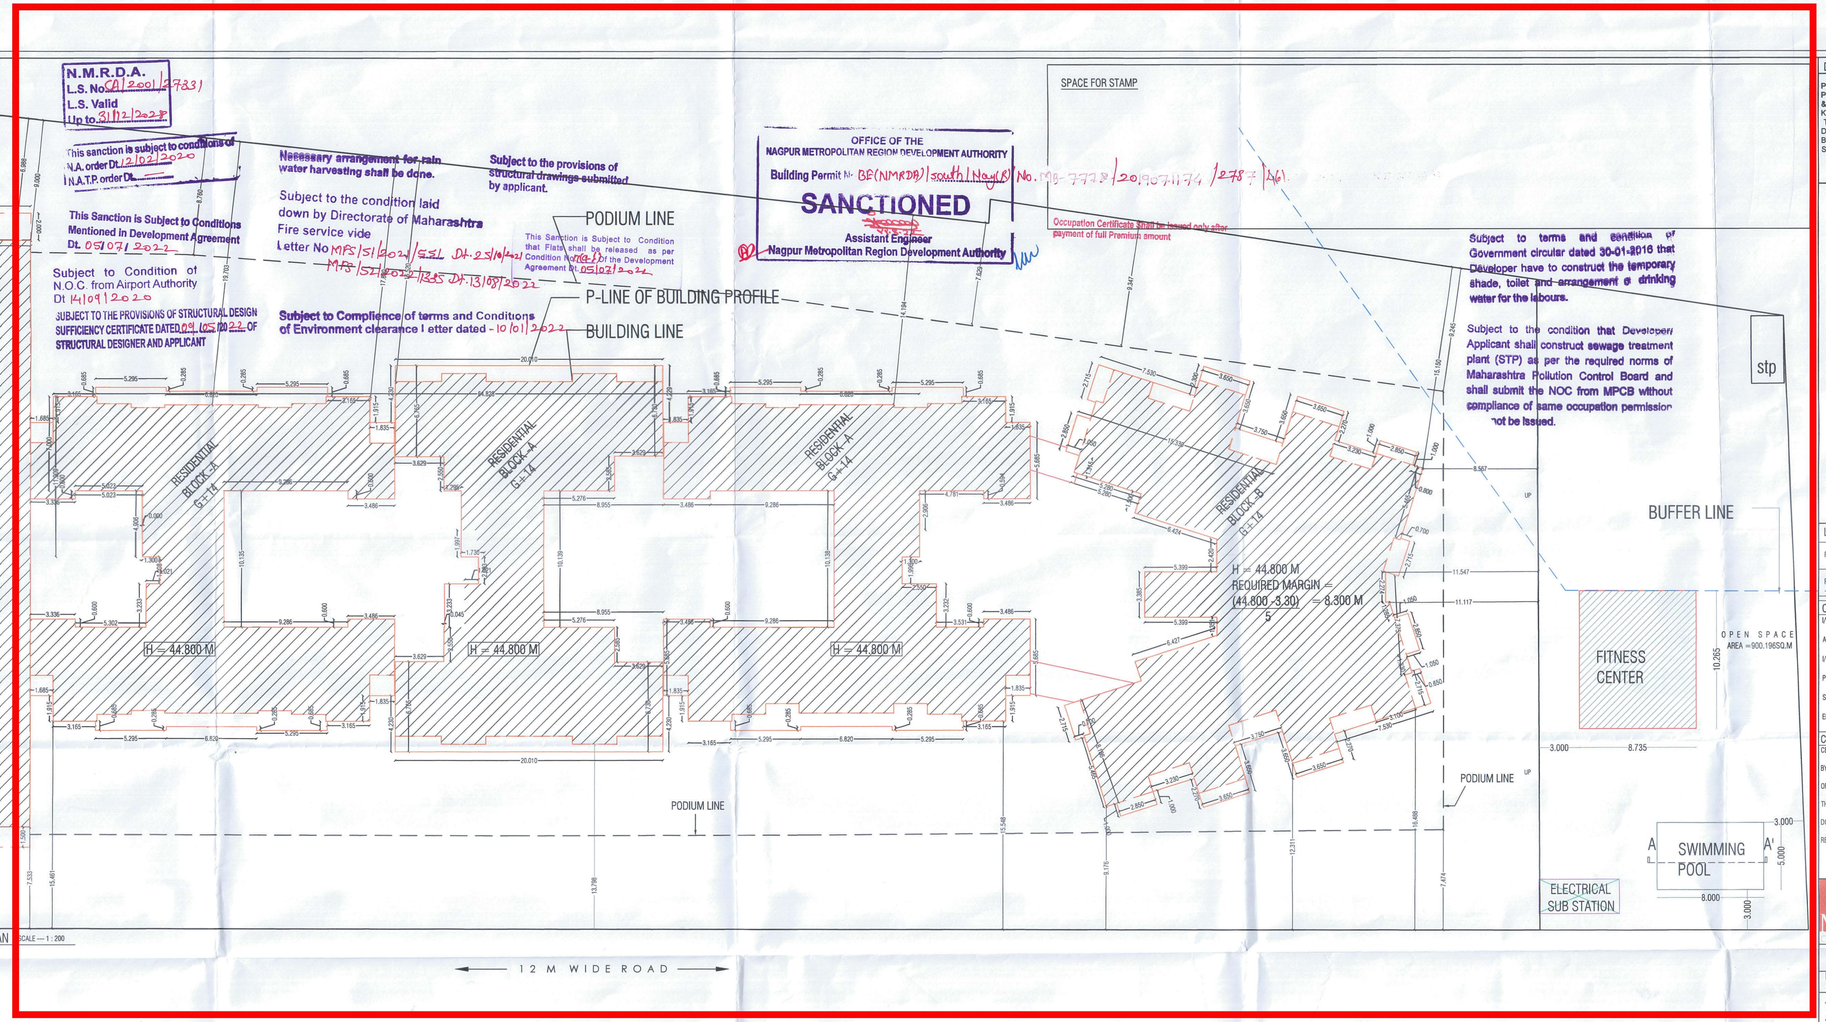


DATE :- 18.08.2021	TITLE:- SITE PLAN	SHEET NO.:- 1/13

PROJECT-
PROPOSED BUILDING PLAN FOR CONSTRUCTION OF COMMERCIAL & MULTIFAMILY DWELLING UNITS ON
KH NO.-36/2, MOUZA- BELTARODI,
TAH-NAGPUR(RURAL),
DIST-NAGPUR.
BELONGING TO- SANDESH INFRASTRUCTURE PVT.LTD.
SHRI DILIP PRALHADRAI AGRAWAL(DIRECTOR)

LEGEND:

PLOT BOUNDARY SHOWN INBLACK

PROPOSED CONSTRUCTION SHOWN IN RED

OWNER'S DECLARATION -

I/WE UNDERSIGNED HEREBY CONFIRM THAT I/WE WOULD ABIDE BY PLANS APPROVED BY AUTHORITY / COLLECTOR. I/WE WOULD EXECUTE THE STRUCTURE AS PER APPROVED PLANS. ALSO I/WE WOULD EXECUTE THE WORK UNDER SUPERVISION OF PROPER TECHNICAL PERSON SO AS TO ENSURE THE QUALITY AND SAFETY AT THE WORK SITE.

OWNER (S) NAME AND SIGNATURE
(POWER OF ATTORNEY)

CERTIFICATE OF AREA:

CERTIFIED THAT THE PLOT UNDER REFERENCE WAS SURVEYED BY ME ON _____ AND THE DIMENSIONS OF SIDES ETC. OF PLOT STATED ON PLAN ARE AS MEASURED ON SITE AND THE AREA SO WORKED OUT TALLIES WITH THE AREA STATED IN DOCUMENT OF OWNERSHIP/ T.P. SCHEME RECORDS/ LAND RECORDS DEPARTMENT/CITY SURVEY RECORDS.

SIGNATURE
A.R. MALEWAR
(CA/2001/27331)(NMC/R-212 & NIT/1337)

M. B. MALEWAR DESIGNS PVT. LTD.
ARCHITECTS, PLANNERS AND INTERIOR DESIGNERS
PROJECT MANAGEMENT & TURNKEY CONSULTANTS
B-WING, LOKMAT BHAWAN, 5TH FLOOR,NAGPUR,MAHARASHTRA
PIN - 440012, INDIA.PH:- OFF: (0712) 2421356 ; (M) 9422102764

FILE PATH:
\\DATASERVER\Architecture\sandesh city\beltarodi\revision3\SANCTION -25-01-2021\BUILDING SUBMISSION

THIS DRAWING IS THE PROPERTY OF M. B. MALEWAR DESIGNS PVT.LTD. AND MUST NOT BE COPIED WITHOUT THEIR WRITTEN CONSENT, NOR MADE KNOWN TO THIRD PARTY.

JOB NO.	DWG. NO.	SCALE	DRAWN BY	CHECKED BY	REGISTRATION NO. OF ARCHITECT
R1	AR/SS/SA /UDCPR/1-A/R1	1:100 1:200	AR.LW	AR. MALEWAR	(CA/2001/27331) (NMC/R-212 & NIT/1337)