

AREA STATEMENT		
1. AREA OF PLOT -		
(a) AS PER OWNERSHIP DOCUMENT	25453.07 SQ.M	
(b) AS PER MEASUREMENT SHEET	25453.07 SQ.M	
(c) AS PER SITE	25453.07 SQ.M	
2. DEDUCTION FOR		
(a) PROPOSED D.P. ROAD, ROAD WIDENING AREA / SERVICE ROAD, HIGHWAY WIDENING	NIL	
(b) ANY D.P. RESERVATION AREA		
(c) TOTAL DEDUCTION	25453.07 SQ.M	
3. BALANCE AREA OF PLOT		
4. AMENITY SPACE (if applicable)		
(a) REQUIRED - 5%	1272.653	SQ.M
(b) ADJUSTMENT OF 20%, IF ANY -		
(c) PROPOSED - 6.82%	1736.895	SQ.M
5. NET PLOT AREA		
6. RECREATIONAL OPEN SPACE (if applicable)		
(a) REQUIRED - 10%	2545.307	SQ.M
(b) PROPOSED (AS PER P.L. 12%)	3054.369	SQ.M
7. INTERNAL ROAD AREA		
8. PLOT AREA (if applicable)		
9. BUILT UP AREA WITH REFERENCE TO 1.5 BASIC F.S.I. AFTER FRONT ROAD WIDTH	188179.61	SQ.M
10. ADDITION OF F.S.I. ON PAYMENT OF PREMIUM (B-30)		
(a) MAXIMUM PREMIUMS PERMANENT F.S.I. BASED ON WIDTH / ZONE D-50%	302	SQ.M
(b) PROPOSED F.S.I. ON PAYMENT OF PREMIUM		
11. IN - SITU F.S.I. / TOR LOADING		
(a) IN - SITU AREA AGAINST D.P. ROAD (20 X 50 SR. NO. 205) - ANY		
(b) IN - SITU AREA AGAINST AMENITY SPACE, IF HANDLED OVER (20 X 50 SR. NO. 205) (AND / OR F.S.I.)		
(c) TOR AREA		
(d) TOTAL IN SITU TOR (AS PROPOSED) (1181+181+181)		
12. ADDITIONAL F.S.I. AREA (UNDER CHAPTER NO. 7)		
13. TOTAL ENTITLEMENT OF F.S.I. IN THE PROPOSAL		
(a) 20% (1181+181) OR 12% WHICHEVER IS APPLICABLE		
(b) ANCILLARY AREA F.S.I. UP TO 5% OR 10% WITH PAYMENT OF CHARGES		
(c) TOTAL ENTITLEMENT (B-10)		
14. MAXIMUM DEDUCTION OF F.S.I. (B-10)		
(a) DEDUCTION OF F.S.I. AS PER ROAD WIDTH (on pro-rata basis, 1:1 or 1:2 on applicable) x 1.5		
15. TOTAL AS BUILT UP AREA (IN PROPOSAL)		
(a) EXISTING BUILT UP AREA	44122.04	SQ.M
(b) PROPOSED BUILT UP AREA (on 1.5 F.S.I.)	1927.772	SQ.M
(c) TOTAL (B-10)	46049.812	SQ.M
16. F.S.I. CONSUMED (115 / 113 SHOULD NOT MORE THAN SERIAL NO. 14 ABOVE)		
17. AREA FOR INCLUSIVE HOUSING, IF ANY		
(a) REQUIRED (20% OF SR. NO. 3)		
(b) PROPOSED		

AS BUILT DRAWING
Approved Subject to Conditions Mentioned
in This Office Letter No.
Dated: 22.7.2019
MAHARASHTRA AIRPORT DEVELOPMENT CO. LTD.
Asst. Chief Architect / T.D.O.

Checked & Found in Order
Asst. Architect

DESCRIPTION OF PROPOSAL

PROPOSED DEVELOPMENT
OF TOWNSHIP

NOTIFIED AREA OF MIHAN AT
MOUZA KHAPRI (R.Y.), NAGPUR
ON PLOT NO. 2, SECTOR - 21.

NAME OF THE OWNER

MAHARASHTRA AIRPORT DEVELOPMENT CO. LTD.
(M.A.D.C.)

8TH FLOOR, WORLD TRADE CENTRE,
CUFFE PARADE, MUMBAI - 400 005

NAME OF THE DEVELOPER

Nagpur Integrated Township Pvt Ltd (NITPL)

Address: H.No 3-71/NR Plot no 71,

Kavuri Hills-II, Madhapur, Hyderabad 500033.

SCALE: 1:500

SIGN (DEVELOPER)

SIGN (ARCHITECT)

ARCHITECT

MR. MAHESH KHANOLKAR


ASSOCIATED ARCHITECTS

501, RAUNAQ APARTMENTS, 14TH ROAD,

CHEMBUR, MUMBAI-400 071

TEL: 022-25210265, 25215269, 25211402

E-MAIL: aarch501@yahoo.com

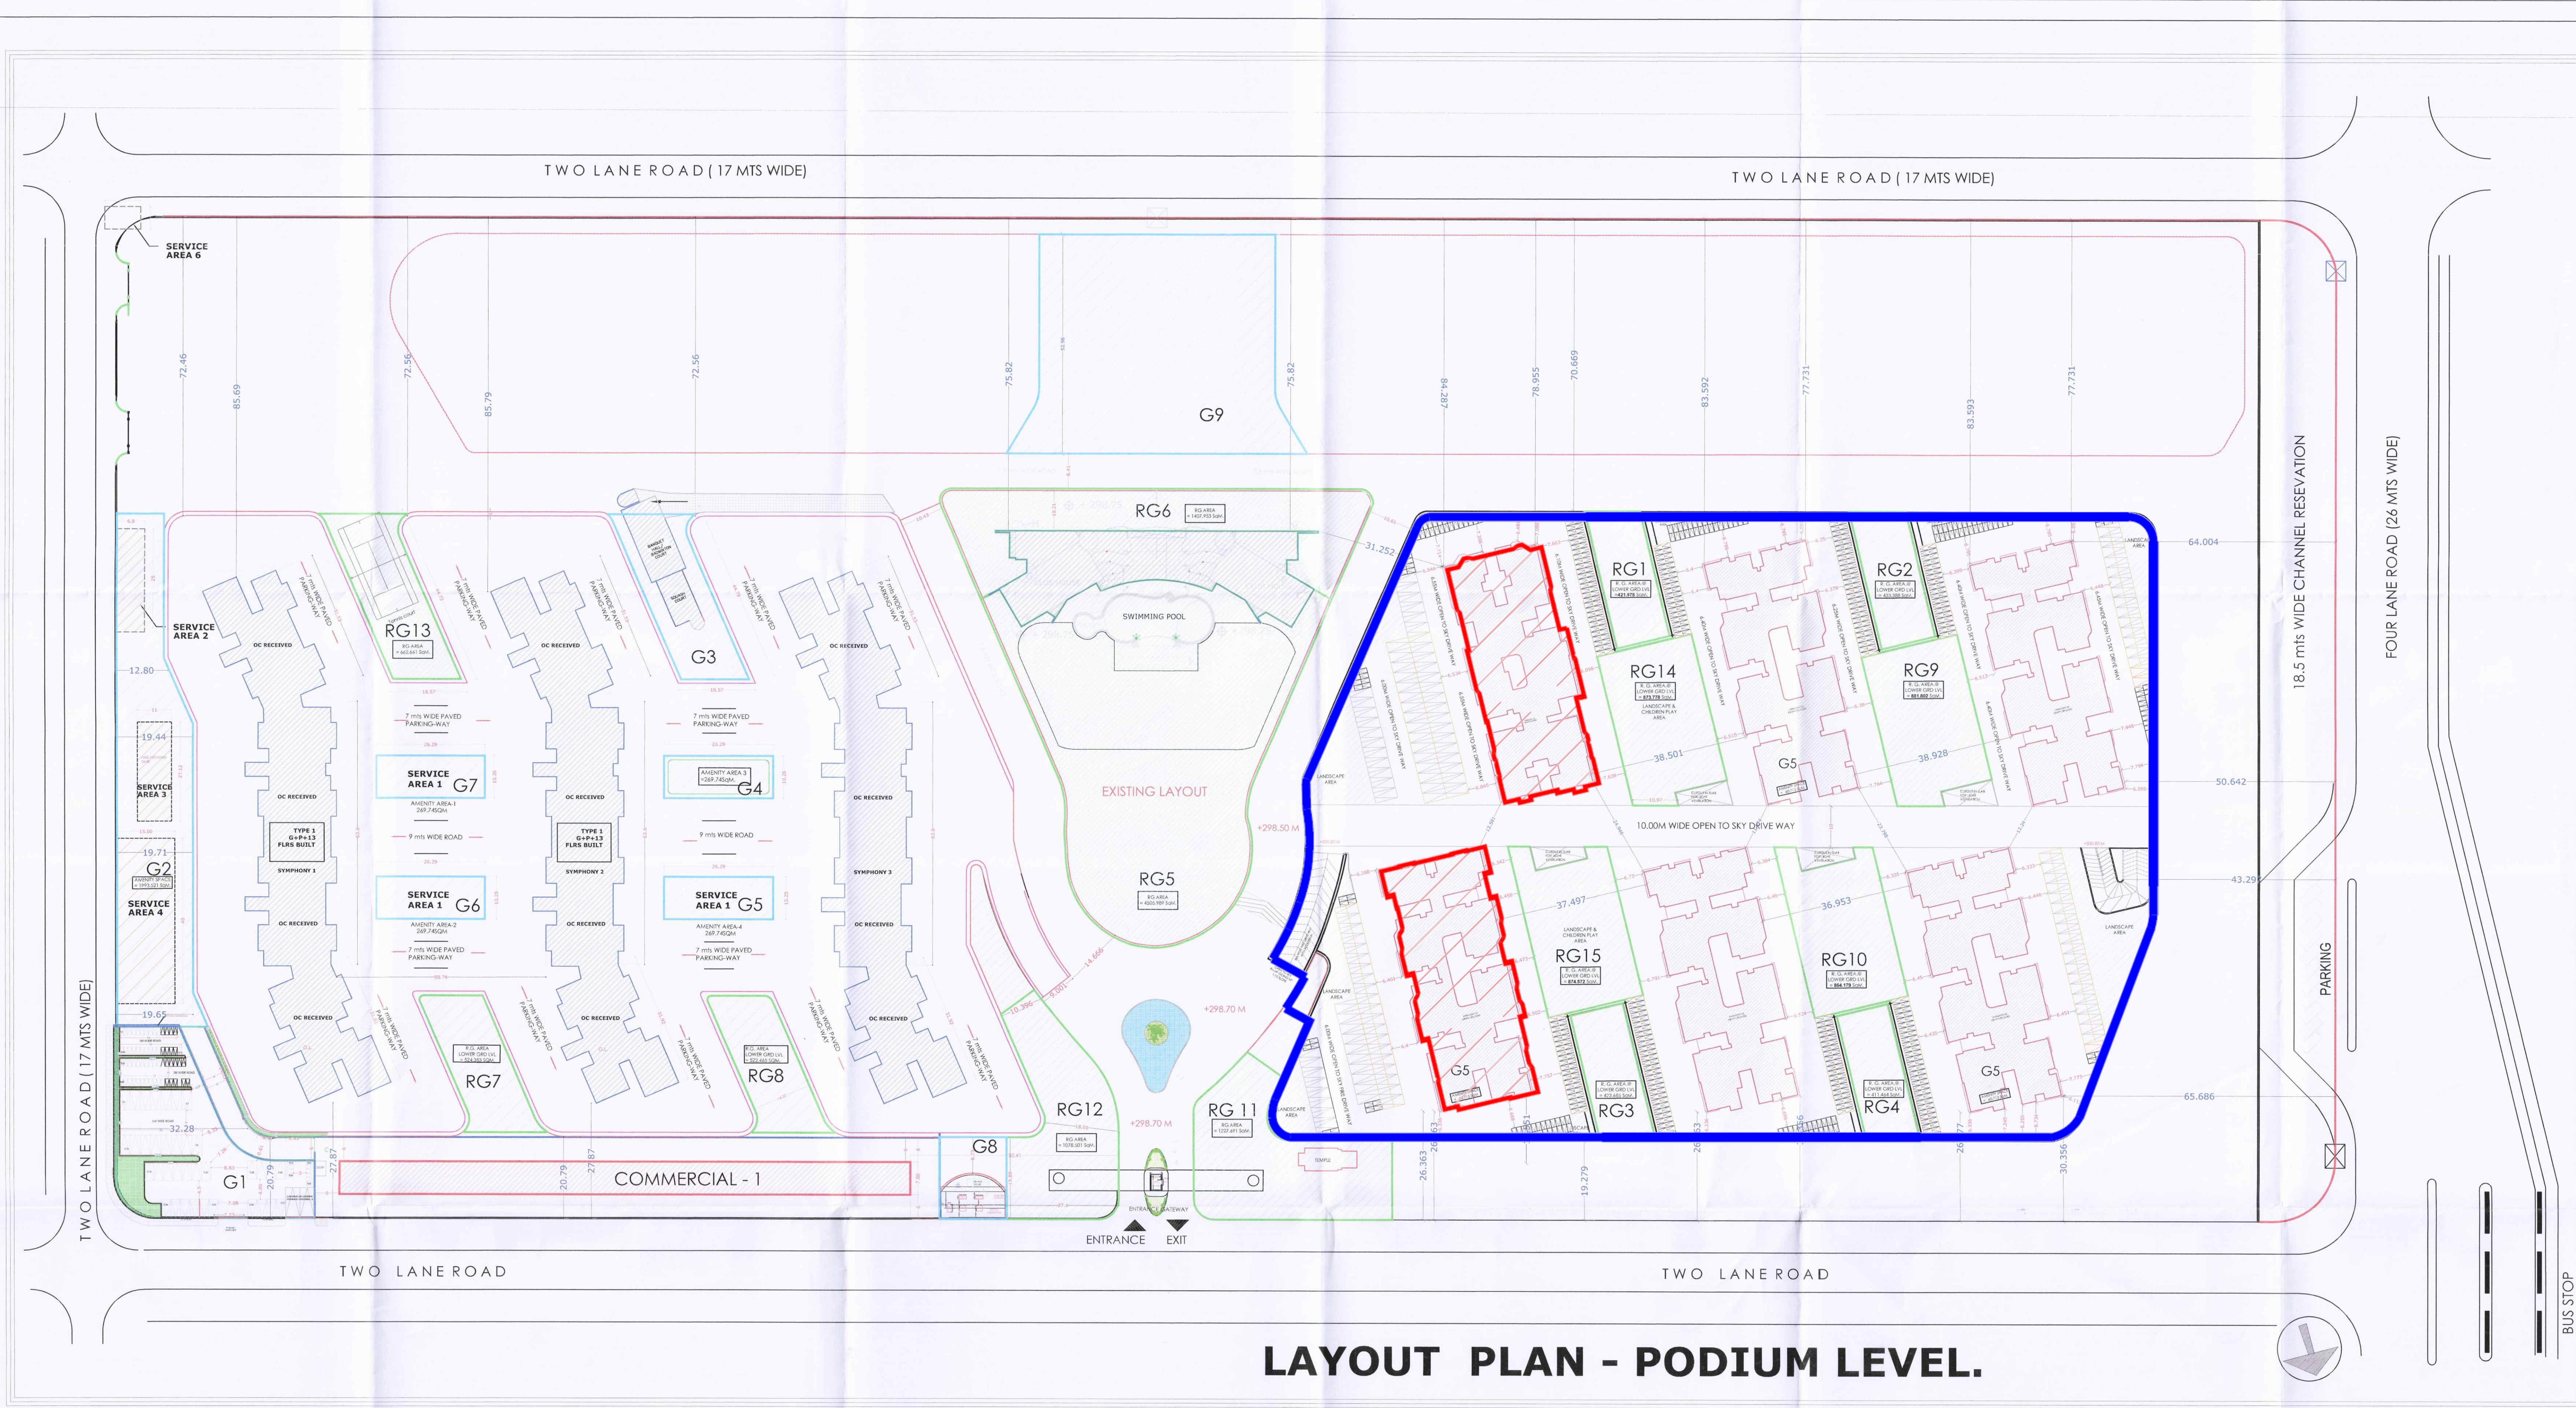

LAYOUT PLAN - PODIUM LEVEL.

NO.	DESCRIPTION	FSI	AREA IN SQ.MT.	GROSS AREA IN SQ.MT.
1	PLOT AREA		125453.073	
2	PERMISSIBLE BASIC FSI	1.500	188179.610	
3	OVERALL PART OCCUPANCY AREA	0.527	66122.041	121251.630
4	APPROVED COMMERCIAL AREA		1908.714	1908.714
5	APPROVED RESIDENTIAL NET BUILT UP AREA		100973.260	155001.863
6	OVERALL APPROVED NET BUILT UP AREA	1.347	169004.015	278162.207
7	AS BUILT UP AREA PROPOSED FOR COMMERCIAL		1927.772	1927.772
8	OVERALL AS BUILT UP AREA	0.542	68049.813	123179.402
9	OVERALL NET BUILT WITH AS BUILT UP AREA	1.347	169023.073	278181.265

RECREATIONAL OPEN SPACES	
RG1	421.978
RG2	433.388
RG3	423.685
RG4	411.464
RG5	4505.989
RG6	1407.953
RG7	524.383
RG8	522.465
RG9	881.802
RG10	864.179
RG11	1227.691
RG12	1078.501
RG13	662.661
RG14	873.778
RG15	874.572
TOTAL AREA	15114.489
PROPOSED	12%

AMENITY SPACES	
G1	1381.206
G2	1993.521
G3	662.492
G4	269.740
G5	269.740
G6	269.740
G7	269.740
G8	323.447
G9	3124.269
TOTAL AREA	8563.895
PROPOSED	6.82%

- EXISTING BUILDING
- PROPOSED FOR OCCUPANCY
- AMENITY SPACE
- RECREATIONAL OPEN SPACE