
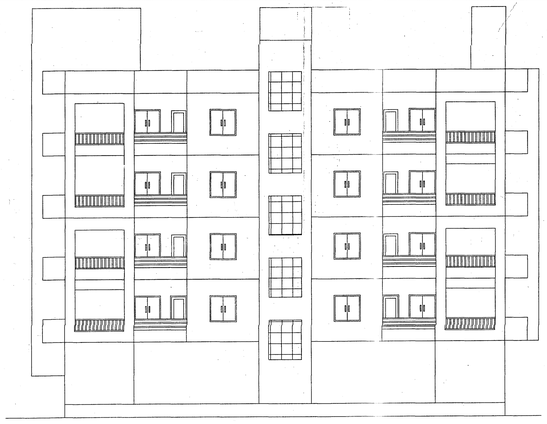



FRONT ELEVATION

SCALE - 1:100

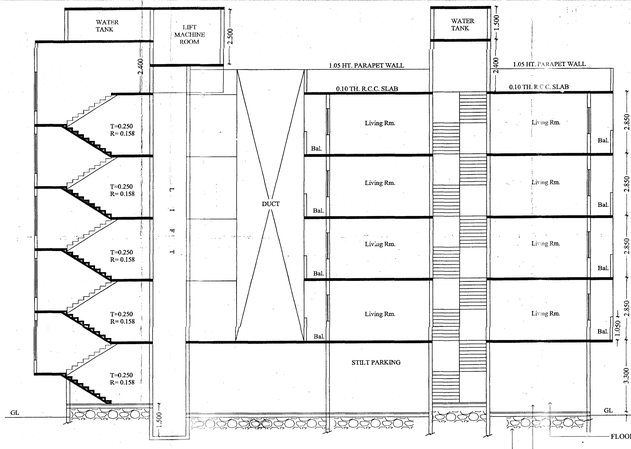

SECTION AT- AA

SCALE - 1:100

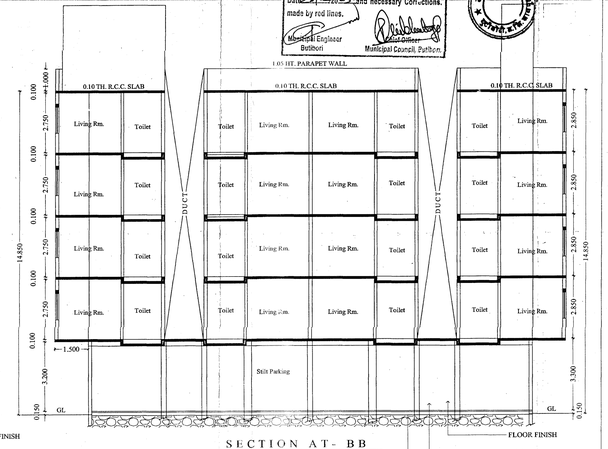


SECTION AT - BB

SCALE - 1:100

Permission granted as per building DCPR by-laws & M.R.T.P. Act-1966, vide letter No. 262 /2023 Date 5/12/2023 and necessary Corrections, made by red lines.

Municipal Engineer
Butibori

Municipal Council, Butibori

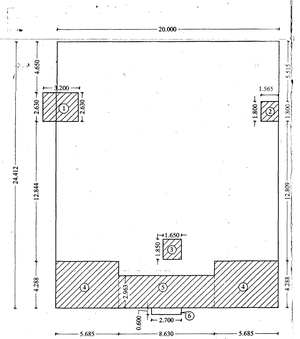


Proposed B/up area on ground Floor

1	3.200	x 2.630	x 1 =	8.42
2	1.565	x 1.800	x 1 =	2.82
3	1.650	x 1.850	x 1 =	3.05
4	5.685	x 4.288	x 2 =	48.75
5	8.630	x 2.963	x 1 =	25.57
6	2.700	x 0.600	x 1 =	1.62
		Total =		90.23

NETB/UP AREA ON FIRST FLOOR

= 90.23 Sqm

GROUND FLOOR
P-LINE BUILT UP AREA KEY PLAN

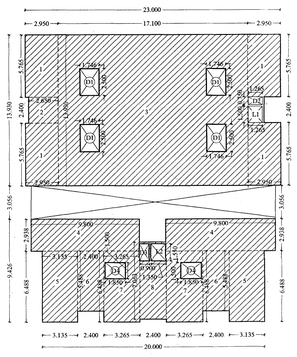

TYPICAL FLOOR (1+2+3+4)
P-LINE BUILT UP AREA KEY PLAN

Proposed B/up area on First Floor


1	2.350	x 5.765	x 4 =	68.03
2	2.650	x 2.400	x 1 =	6.36
3	17.100	x 13.930	x 1 =	238.20
4	9.800	x 2.938	x 2 =	57.56
5	3.135	x 6.488	x 2 =	40.68
6	2.400	x 5.488	x 2 =	26.34
7	3.265	x 6.488	x 2 =	42.37
8	2.400	x 7.063	x 1 =	16.95
		Total =		496.51

Deduct

D1	1.746	X 2.500	X 4 =	17.46
D2	1.265	X 0.750	X 1 =	0.95
L1	1.265	X 1.500	X 1 =	1.90
D3	0.800	X 1.550	X 1 =	1.40
L2	1.350	X 1.550	X 1 =	2.09
D4	1.850	X 1.500	X 2 =	5.55
		Total =		29.34


NETB/UP AREA ON FIRST FLOOR

= 467.17 Sqm

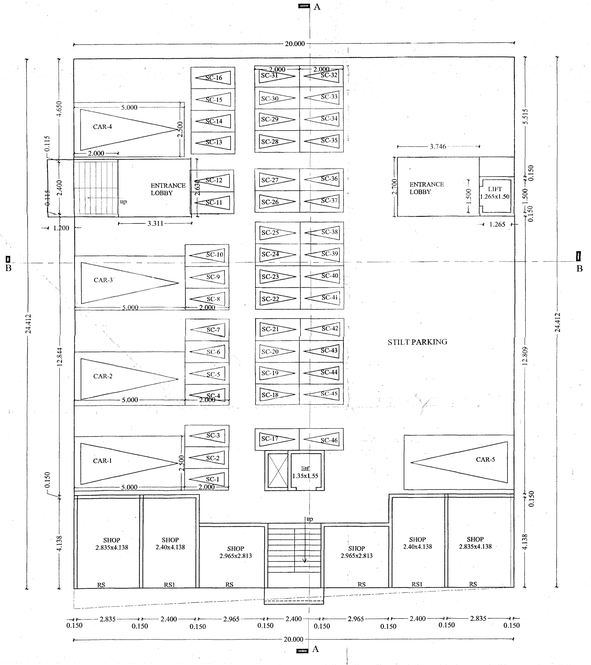

PROPOSED GROUND FLOOR PLAN


SCALE - 1:100

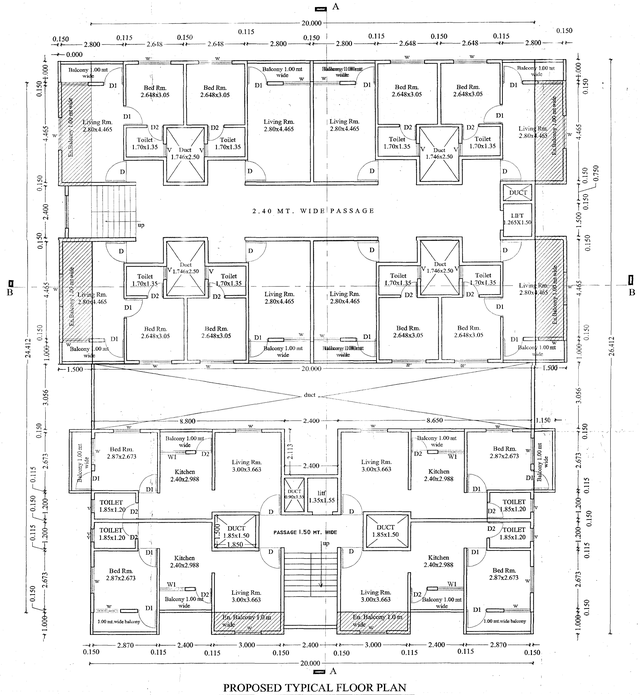

PROPOSED TYPICAL FLOOR PLAN

FIRST , SECOND , THIRD & FOURTH FLOOR

scale : 1:100

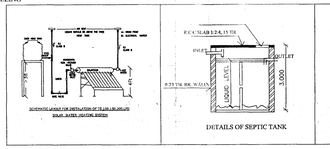
P.C.C SLAB 1:2:4, 15 TH.
INLET
OUTLET
P.C.C 1:2:4 TH. BOTTOM
P.C.C 1:2:4 TH. SIDE WALLS
1.000
1.000
1.000
1.000
GL
GRAVEL
CHARCOAL
BRICK BAT COBA
SAND